




PROFILE C-C  
(1" = 2')

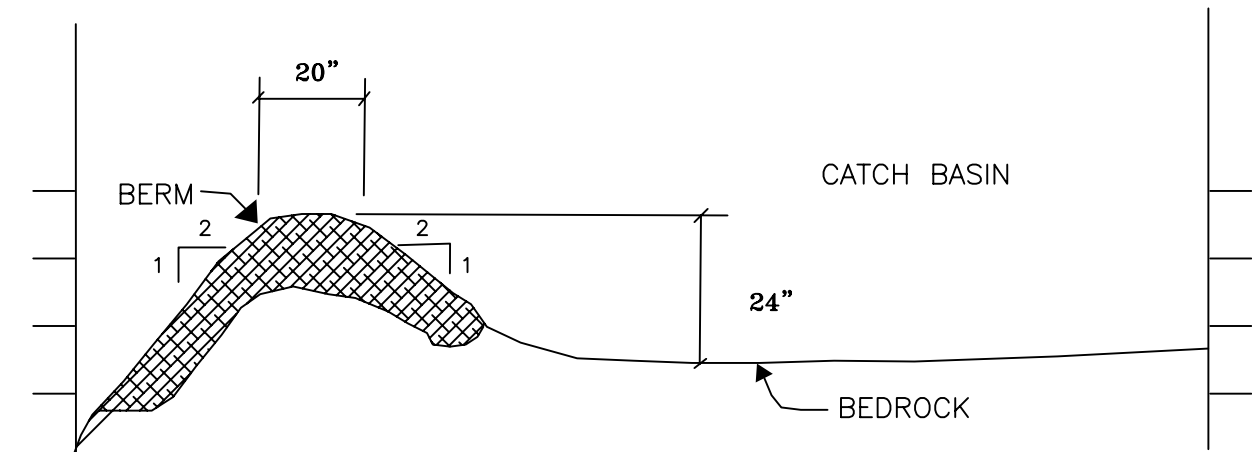

PROFILE B-B  
(1" = 2')

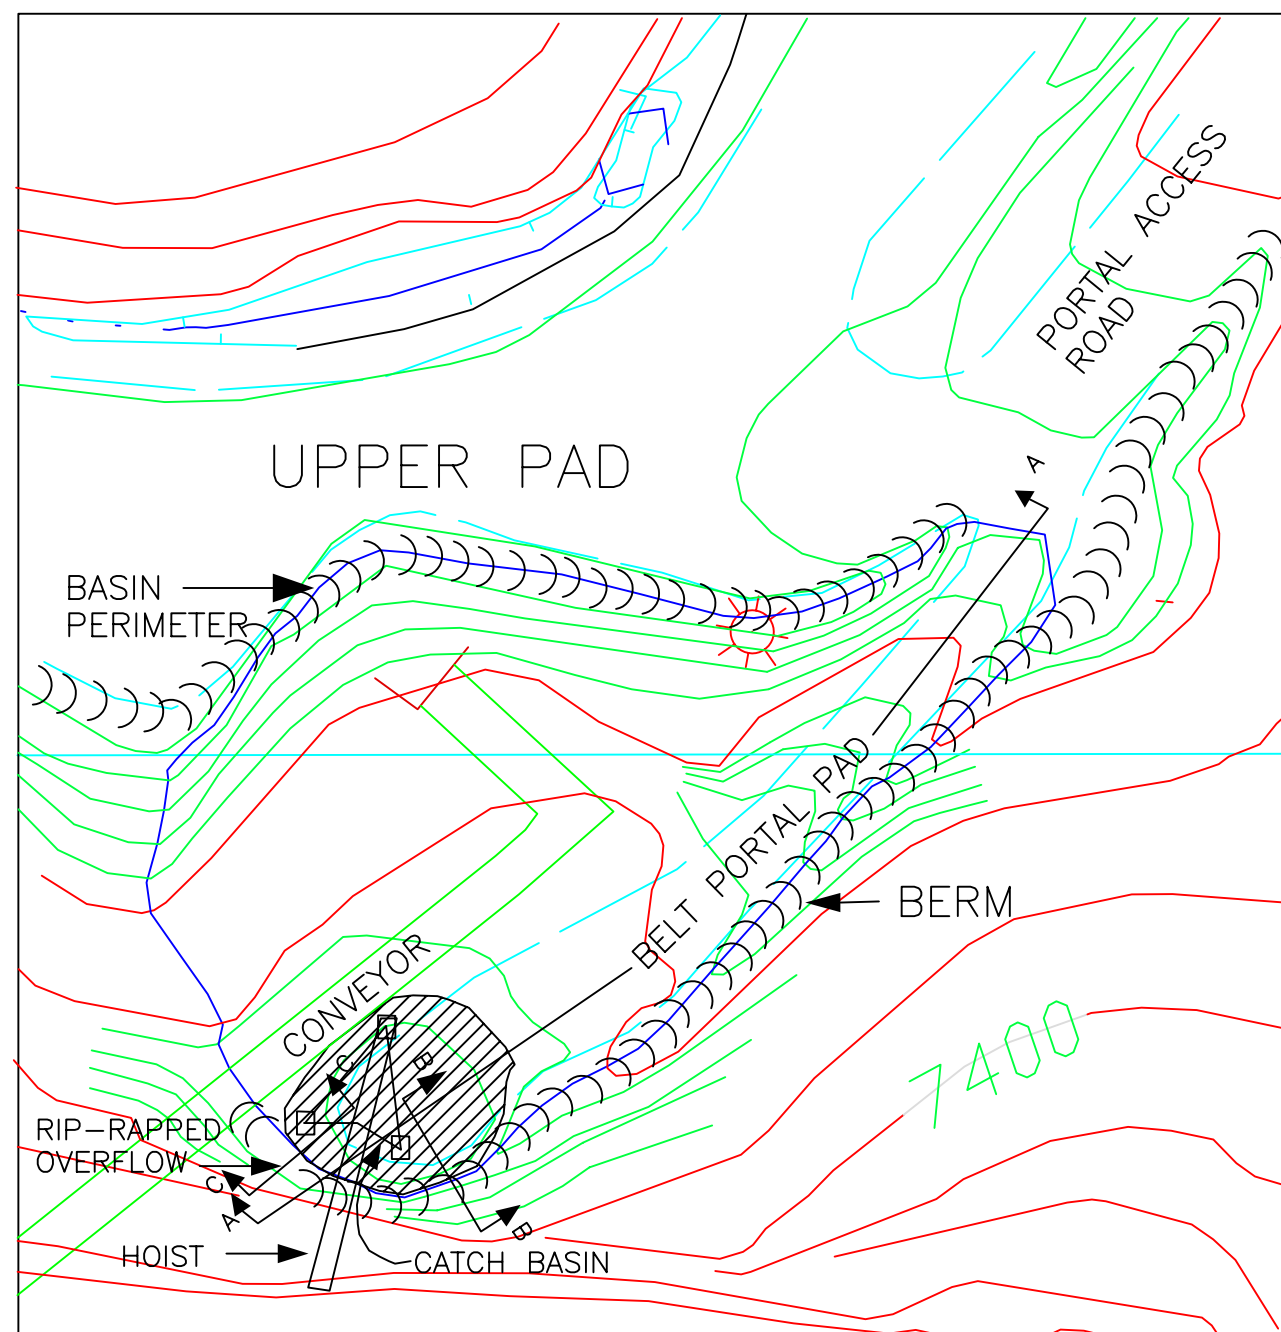

PLAN VIEW

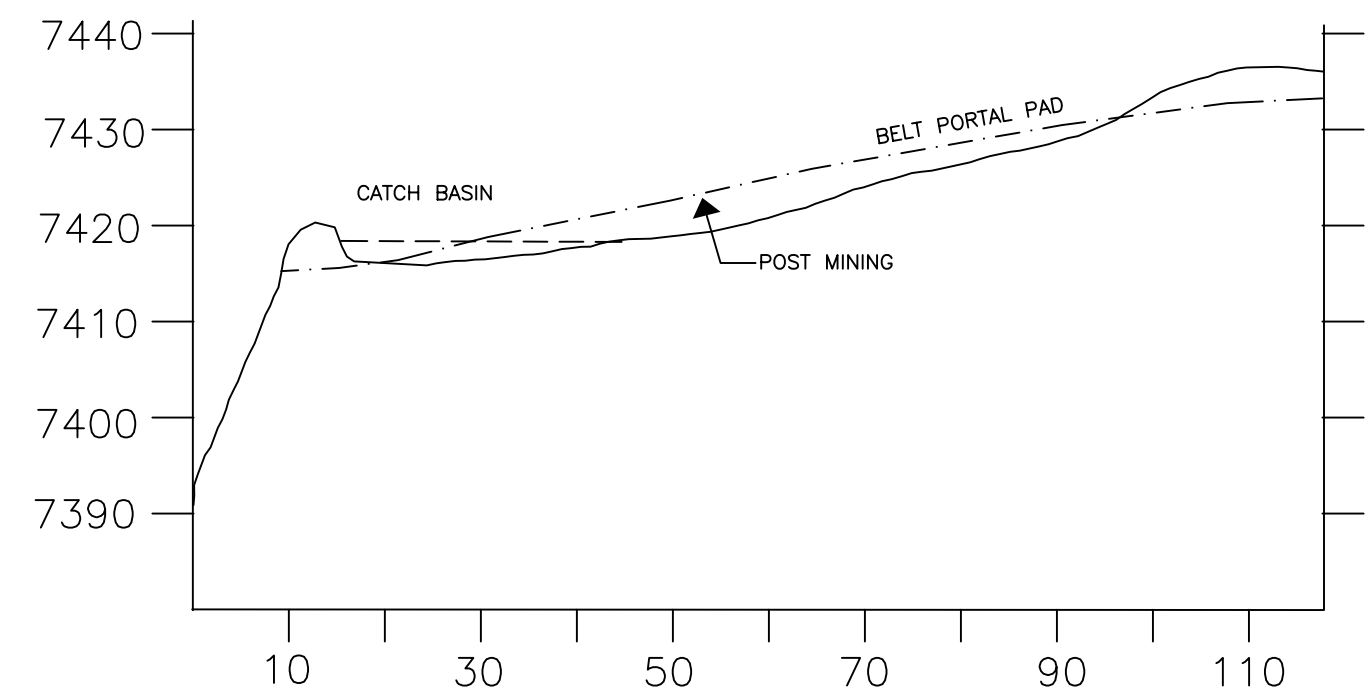

BELT PORTAL PAD PROFILE A-A  
(1" = 20')

REV.	DATE	REMARKS	APPR.
1	7/12/93	Designated as belt portal pad (93E)	9/16/93
2	8/01/02	Changed name from 3-6 to 5-5	
3			
4			
5			
6			
7			
8			
9			
10			

CO-OP MINING CO.		
HUNTINGTON, UTAH		
AS-BUILT BELT PORTAL PAD DETAILS		
SCALE: 1" = 20'	DRAWN BY: C. Reynolds	DATE: 6/20/91
BEAR CANYON		PLATE 5-5